LEGEND

CENTER LINE

RIGHT-OF-WAY

PROPERTY LINE

x 11.2 EXISTING GRADE ELEVATION (NGVD '29)

Sunshine 811

Call 811 or visit sunshine811.com two full business days before digging to have buried facilities located and marked.

Check positive response codes before you dig!

RECEIVED
By Massiel at 10:14 am, May 26, 2026

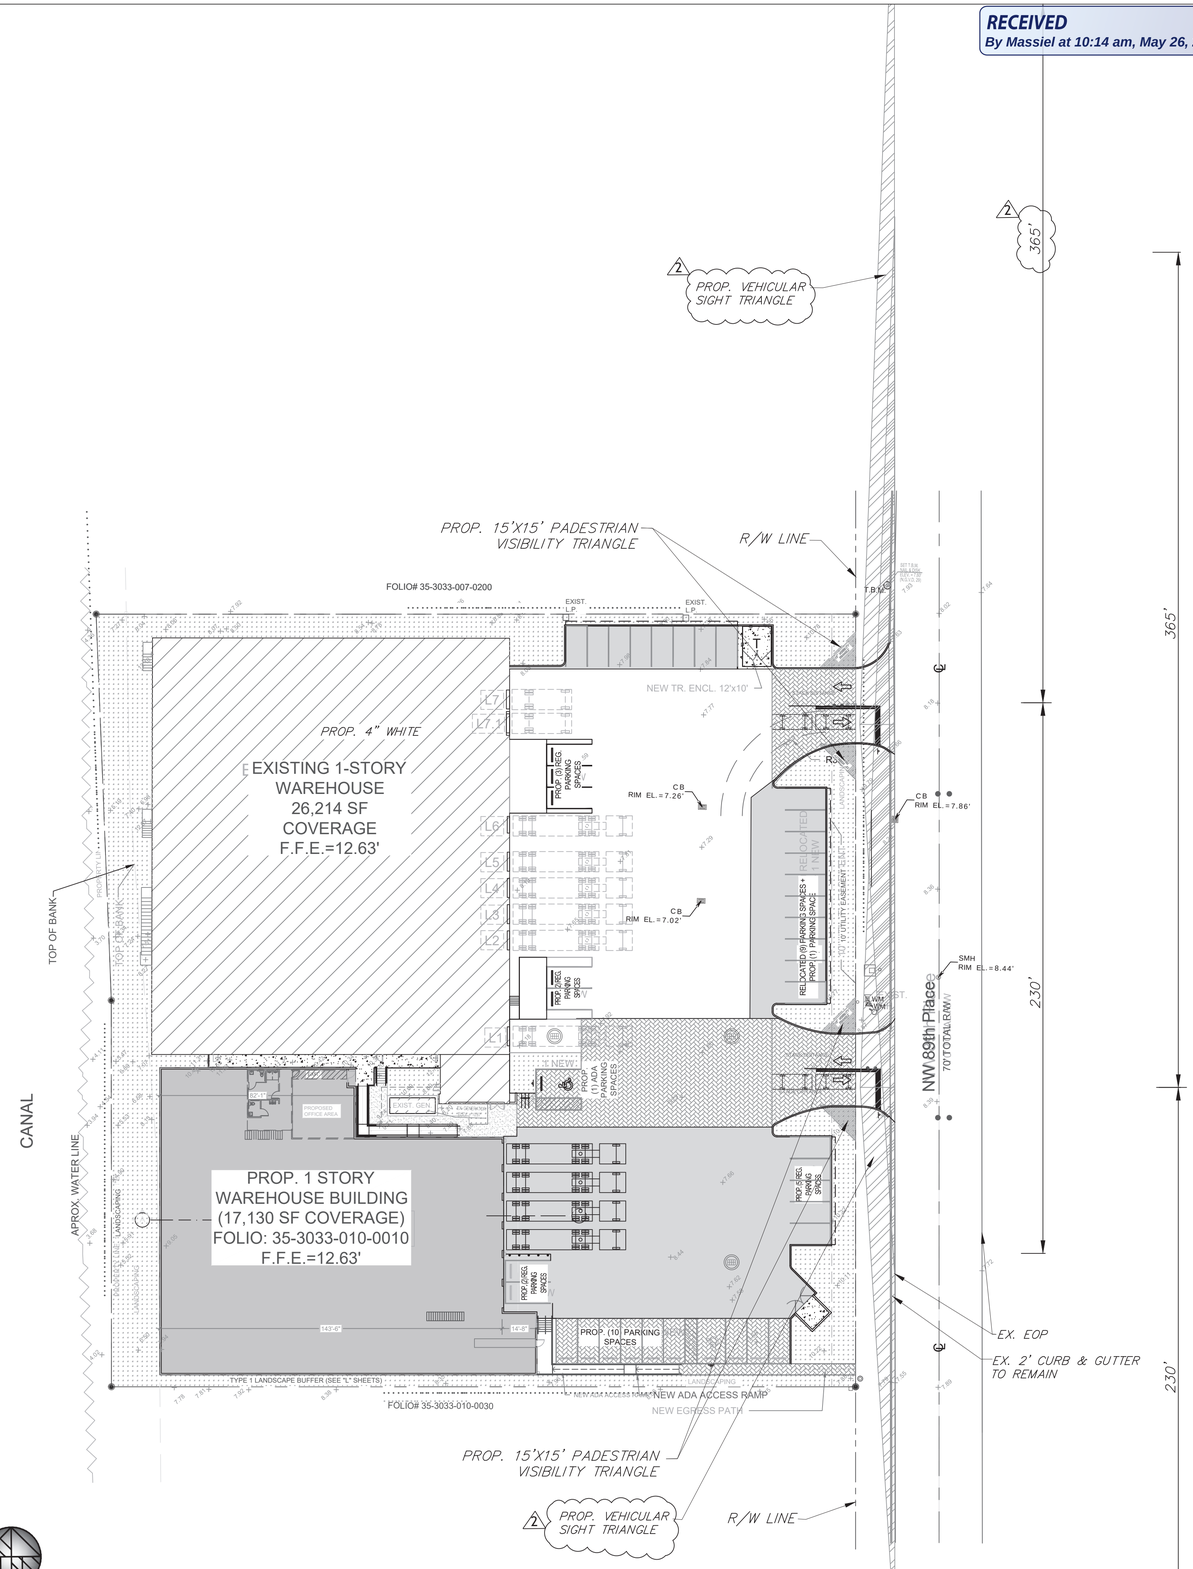

PEDESTRIAN & VEHICULAR SIGHT TRIANGLE PLAN - PLAN VIEW

SCALE: 1" = 30'-0"

EA3 CIVIL ENGINEERING

EA3 CIVIL ENGINEERING, INC.
9050 PINES BLVD., STE. 415-415
PEMBROKE PINES, FLORIDA 33024
OFFICE: 754.777.7993
WWW.EA3CIVIL.COM

CA NO. 32522
PE NO. 82291
ERIC ARENCIBIA, P.E.

SEAL:

ERIC ARENCIBIA LICENSE No 82291 STATE OF FLORIDA PROFESSIONAL ENGINEER

Digitally signed by Eric Arencibia
DN: CN=Eric Arencibia, 9=Qualifier=A01410000000192448D04E50001EBCD, O=Unaffiliated, C=US
Reason: This item has been digitally signed & sealed by Eric Arencibia, P.E. on the date adjacent to the seal. Printed copies of this document are not considered signed & sealed and the signature must be verified on any electronic copies.
Date: 2026.05.15 14:15:02-04'00'

ERIC ARENCIBIA, P.E.
NO. 82291, STATE OF FLORIDA

PROJECT NAME & ADDRESS: DORAL WAREHOUSE, 2020 NW 89TH PLACE, DORAL, FL 33141

PROPOSED NEW FACILITY:

DORAL WAREHOUSE

THIS DRAWING CONTAINS PROPRIETARY INFORMATION AND IS THE PROPERTY OF "MEC DESIGN CONSULTANTS, INC." AND MAY NOT BE REPRODUCED OR DISTRIBUTED WITHOUT THE WRITTEN PERMISSION OF "MEC DESIGN CONSULTANTS, INC."

REVISION NO.	DATE	BY
1	12-16-25	REVIEW COMMENTS
2	04-30-26	REVIEW COMMENTS

CHECKED BY: E.A.

DRAWN BY: A.L.

DATE: 10/02/2025

SHEET TITLE:

PEDESTRIAN & VEHICULAR SIGHT TRIANGLE PLAN

SHEET:

C-301